


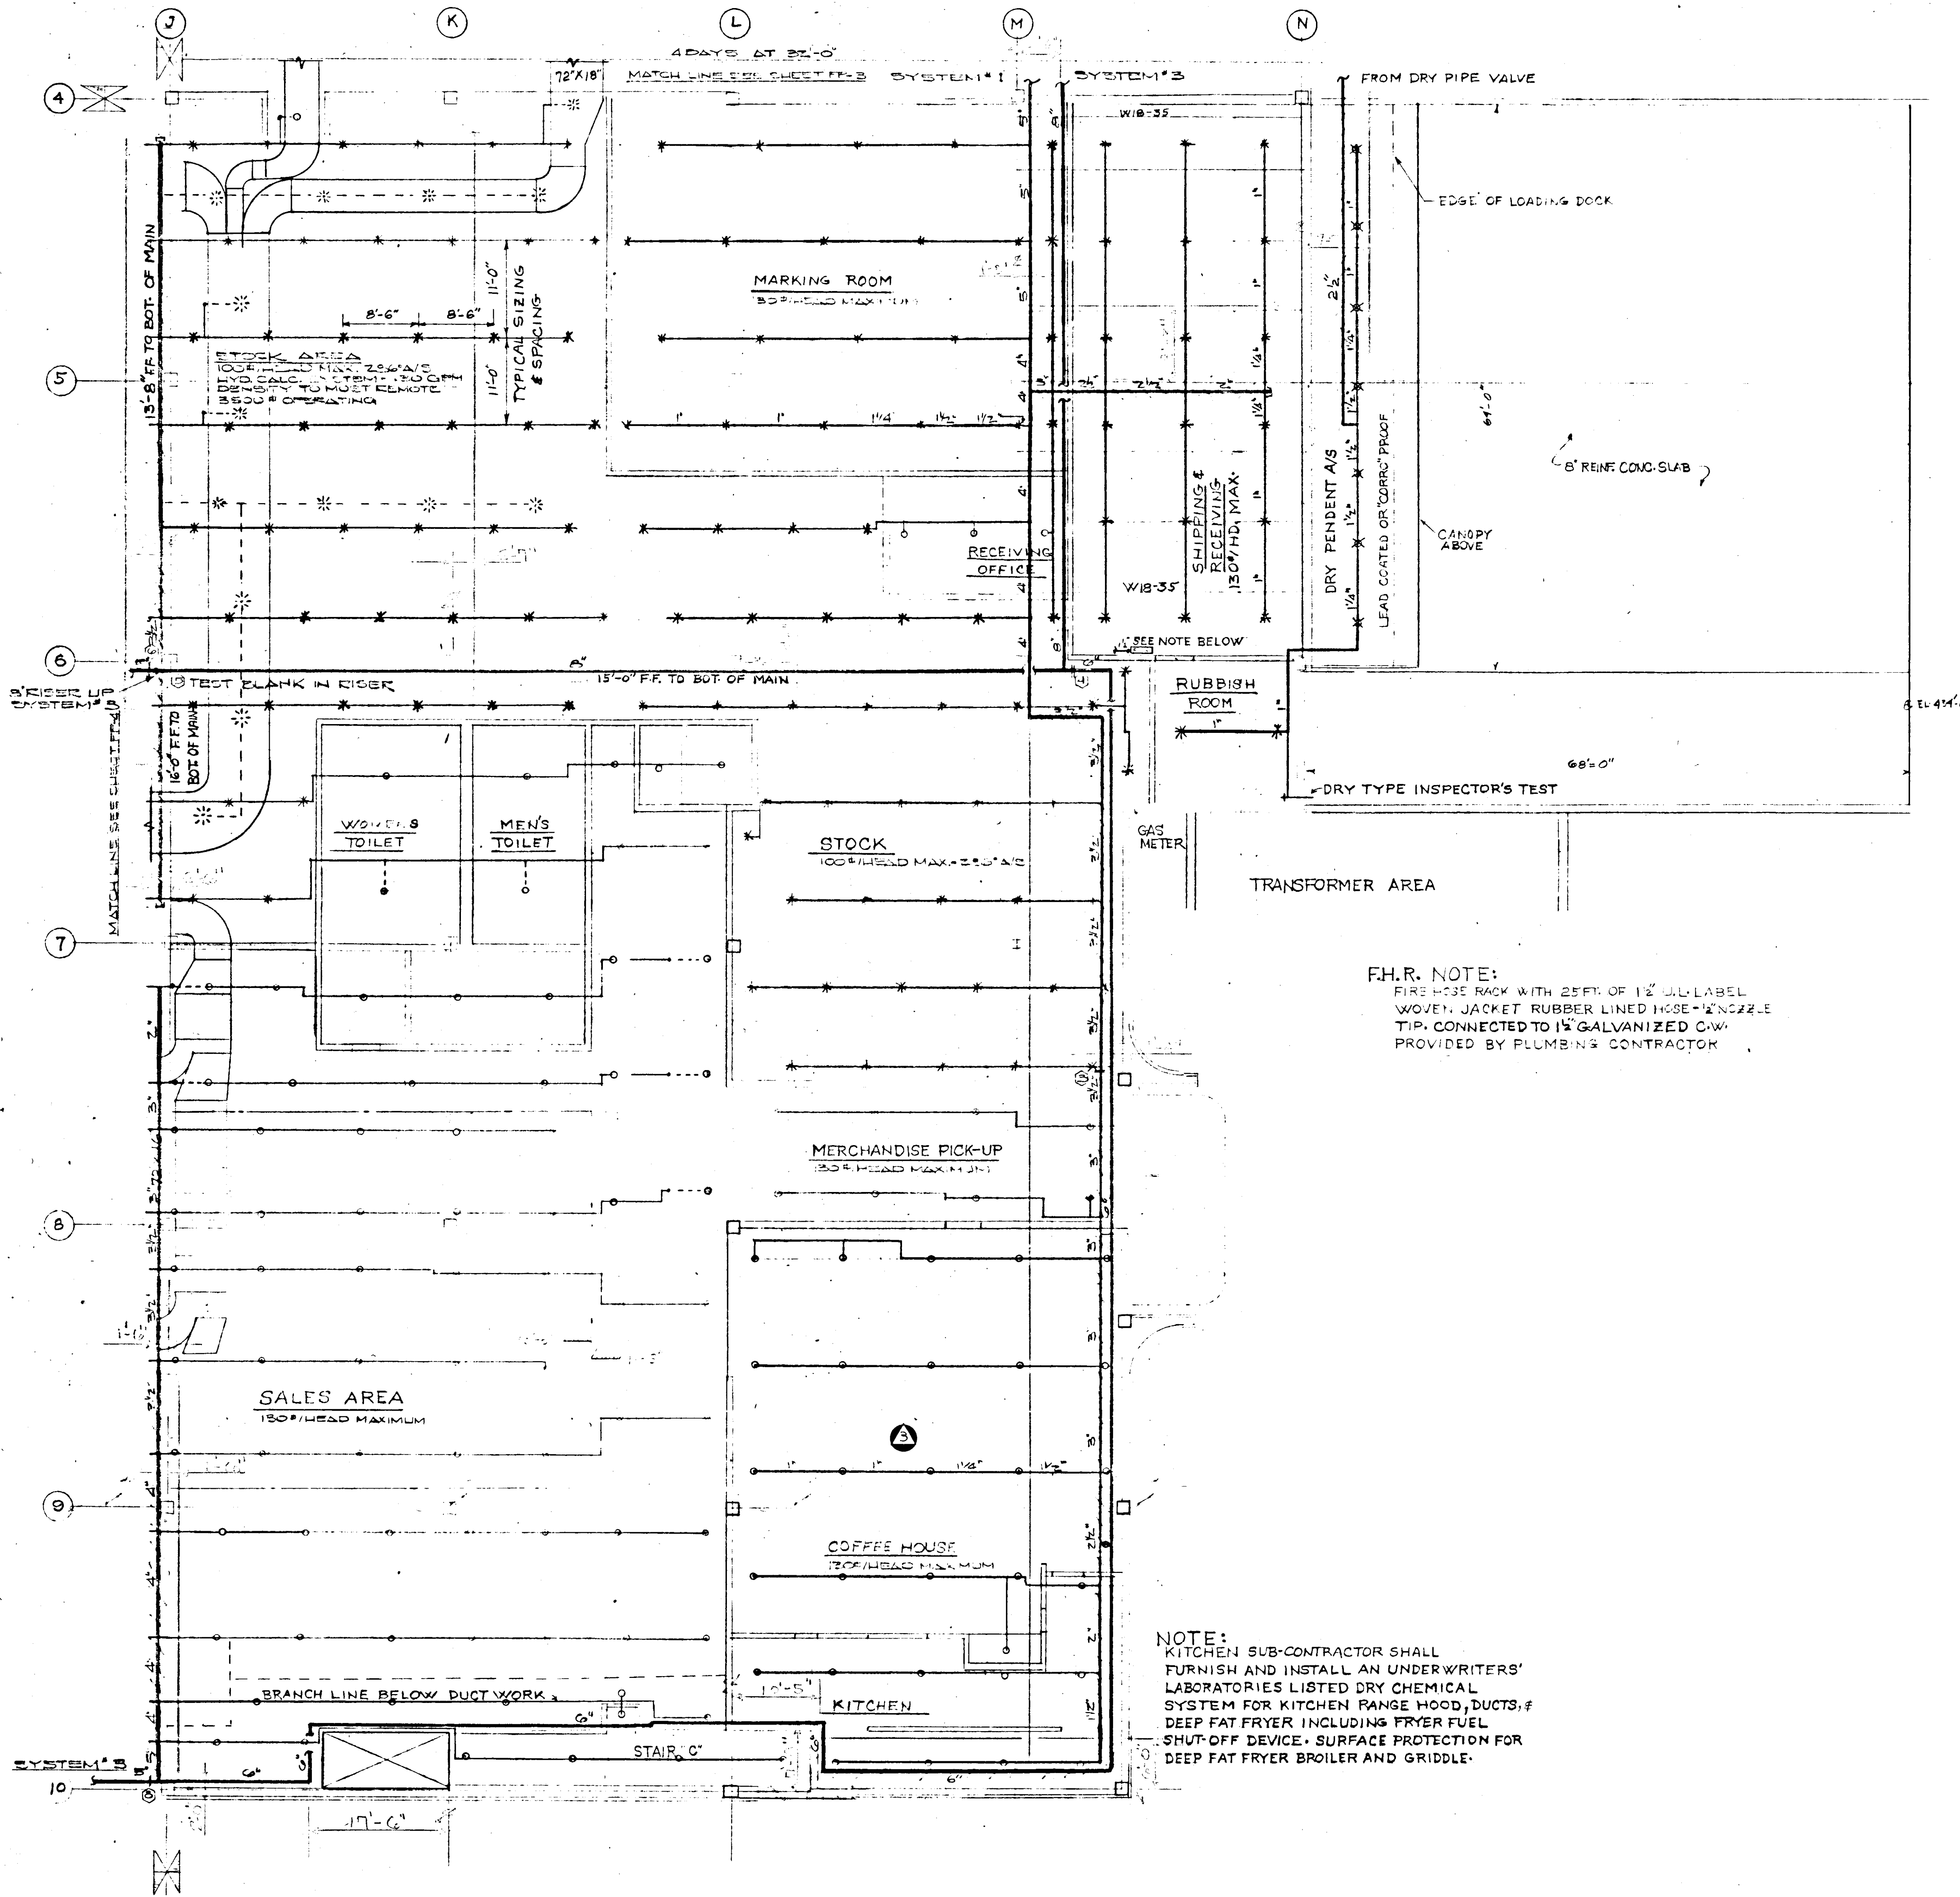

F.H.R. NOTE:
FIRE HOSE RACK WITH 25 FT. OF 1 1/2" J.L. LABEL
WOVEN JACKET RUBBER LINED HOSE - 1" NOZZLE
TIP. CONNECTED TO 1 1/2" GALVANIZED C.W.
PROVIDED BY PLUMBING CONTRACTOR

NOTE:
KITCHEN SUB-CONTRACTOR SHALL
FURNISH AND INSTALL AN UNDERWRITERS'
LABORATORIES LISTED DRY CHEMICAL
SYSTEM FOR KITCHEN RANGE HOOD, DUCTS, &
DEEP FAT FRYER INCLUDING FRYER FUEL
SHUT-OFF DEVICE. SURFACE PROTECTION FOR
DEEP FAT FRYER BROILER AND GRIDDLE.

ELECTRONIC CONTROL #
R1634 092 FP6

AS BUILT DRAWING

FEB. 7, 1972

PREPARED BY
SCHIRMER ENGINEERING CORP.
FIRE PROTECTION CONSULTANTS
2940 W. TOWNE AVENUE
NILES, ILLINOIS

ABM

ALLAN B. MITCHELL and ASSOCIATES ARCHITECTS PITTSBURGH, PA.

FIRST FLOOR - QUADRANT N^o 4 -
RETAIL STORE and 23 CAR AUTO SERVICE
SEARS ROEBUCK & COMPANY
SECURITY SQUARE - BALTIMORE WEST, MARYLAND

SCALE V3 = 1'-0"
DATE JULY 1, 1971
REVISED 2-7-72
BY [signature]

DRAWING NUMBER
FP-5